


COMPARTMENT - PASSENGER SIDE

COMPARTMENT - DRIVER SIDE

CAB

10C #16

5C #16

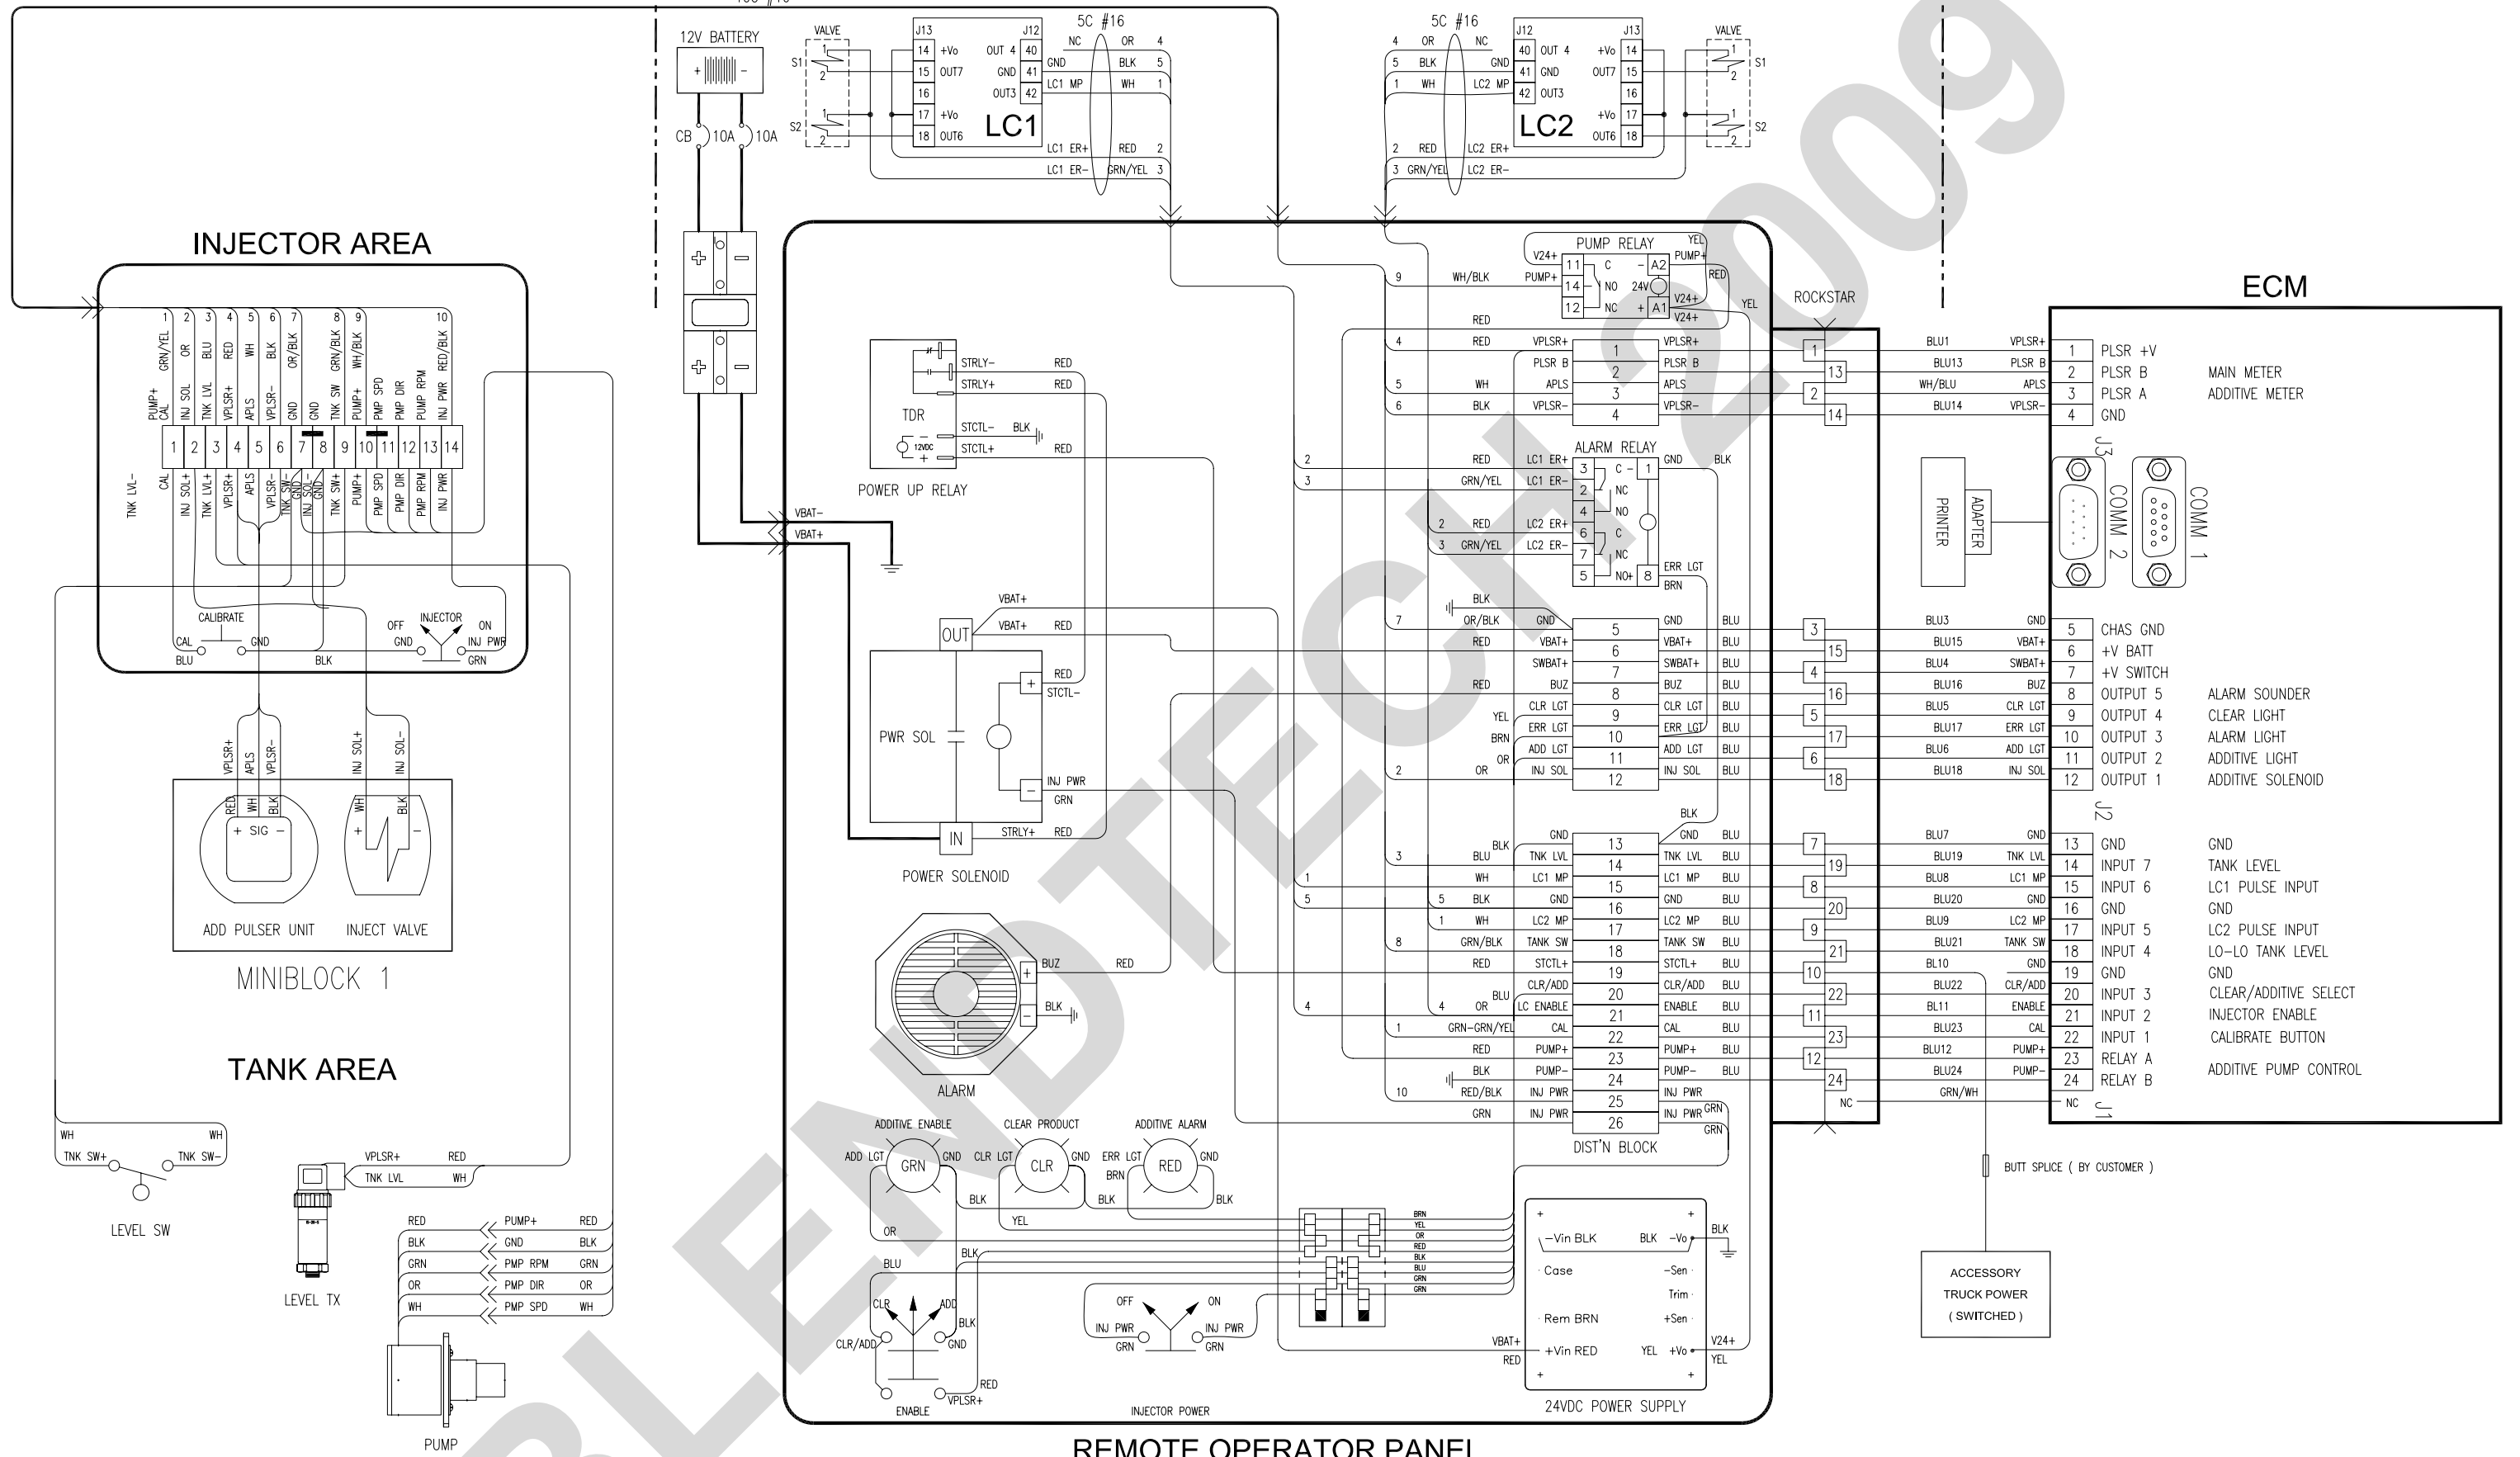

NO	DATE	REVISION	BY
3	03/10/09	REVISED WIRING ON LC1 & LC2	JGM
2	02/11/09	AS BUILT	JGM
1	10/13/08	ISSUED FOR CONSTRUCTION	JGM

BLENDTECH
 216 RIVERMEDE ROAD, UNIT 1 & 2
 CONCORD, ONTARIO
 (905) 669-5712

TITLE	SCALE: NTS	LOCN	IMPERIAL OIL MISSISSAUGA, ON		
ECM TRUCK INJECTOR – ESSO AVITAT SCHEMATIC NATIONAL ENERGY EQUIPMENT INC.	DATE: 10/08/08	JOB NO	DWG NO	SHT NO	
	DWN BY: JGM	14328	B14328-3	1	
	CHKD:				
	APPD:				